



BROADWAY EAST

Suite 240

As-Built 2,687 Sq. Ft.

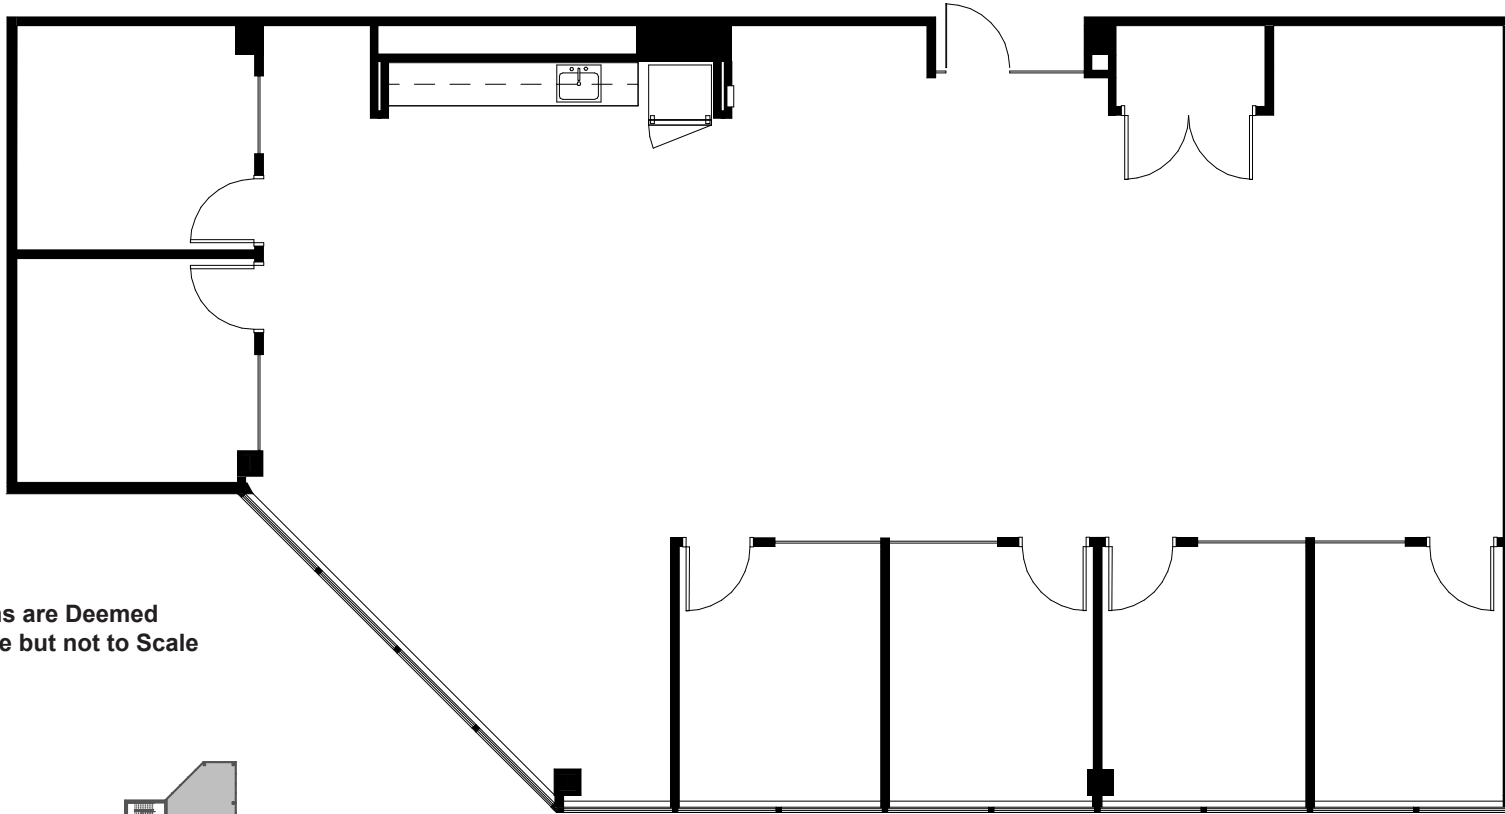

* Dimensions are Deemed
as Accurate but not to Scale

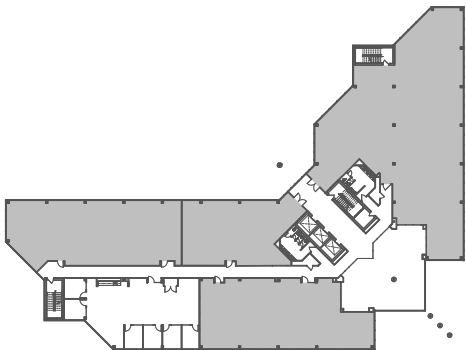

OWNED & MANAGED BY



LEASED BY

